


FÖRKLARINGAR

BRANDCELLSMARKERINGAR

- E30 - - - - -
- E160 - - - - -
- E120 - - - - -
- [UT] BELYST ELLER GEMINLYST NÖDUTRYMNSSKYLT
- [] MÖNSTERKÄNNING FÖR GOLVMATERIAL
- [] PUSHLÖD, FÄRDIGT GOLV
- [] PUSHLÖD, BJÄLKLAG
- [] GOLVDETALI. SE GOLVDETALRITNING

HÄNVISNINGAR

- VÄGTYPER: SE RITN. E36-99 001
- WC/BADRUMSTYPER: SE RITN. E75-99 001
- GÅRDERSSTYPER: SE RITN. E76-99 001
- KÖNSTYPER: SE RITN. E77-99 001
- FÖNSTERAPPARATER: SE RITN. E79-99 003
- GOLVDETALER: SE RITN. E72-99 010
- GOLVDETALER I KORRIDOR OCH TRAPPHUS SE SCSA-RITNINGAR
- NV. GLASPARTIER: SE RITN. E65-99 101

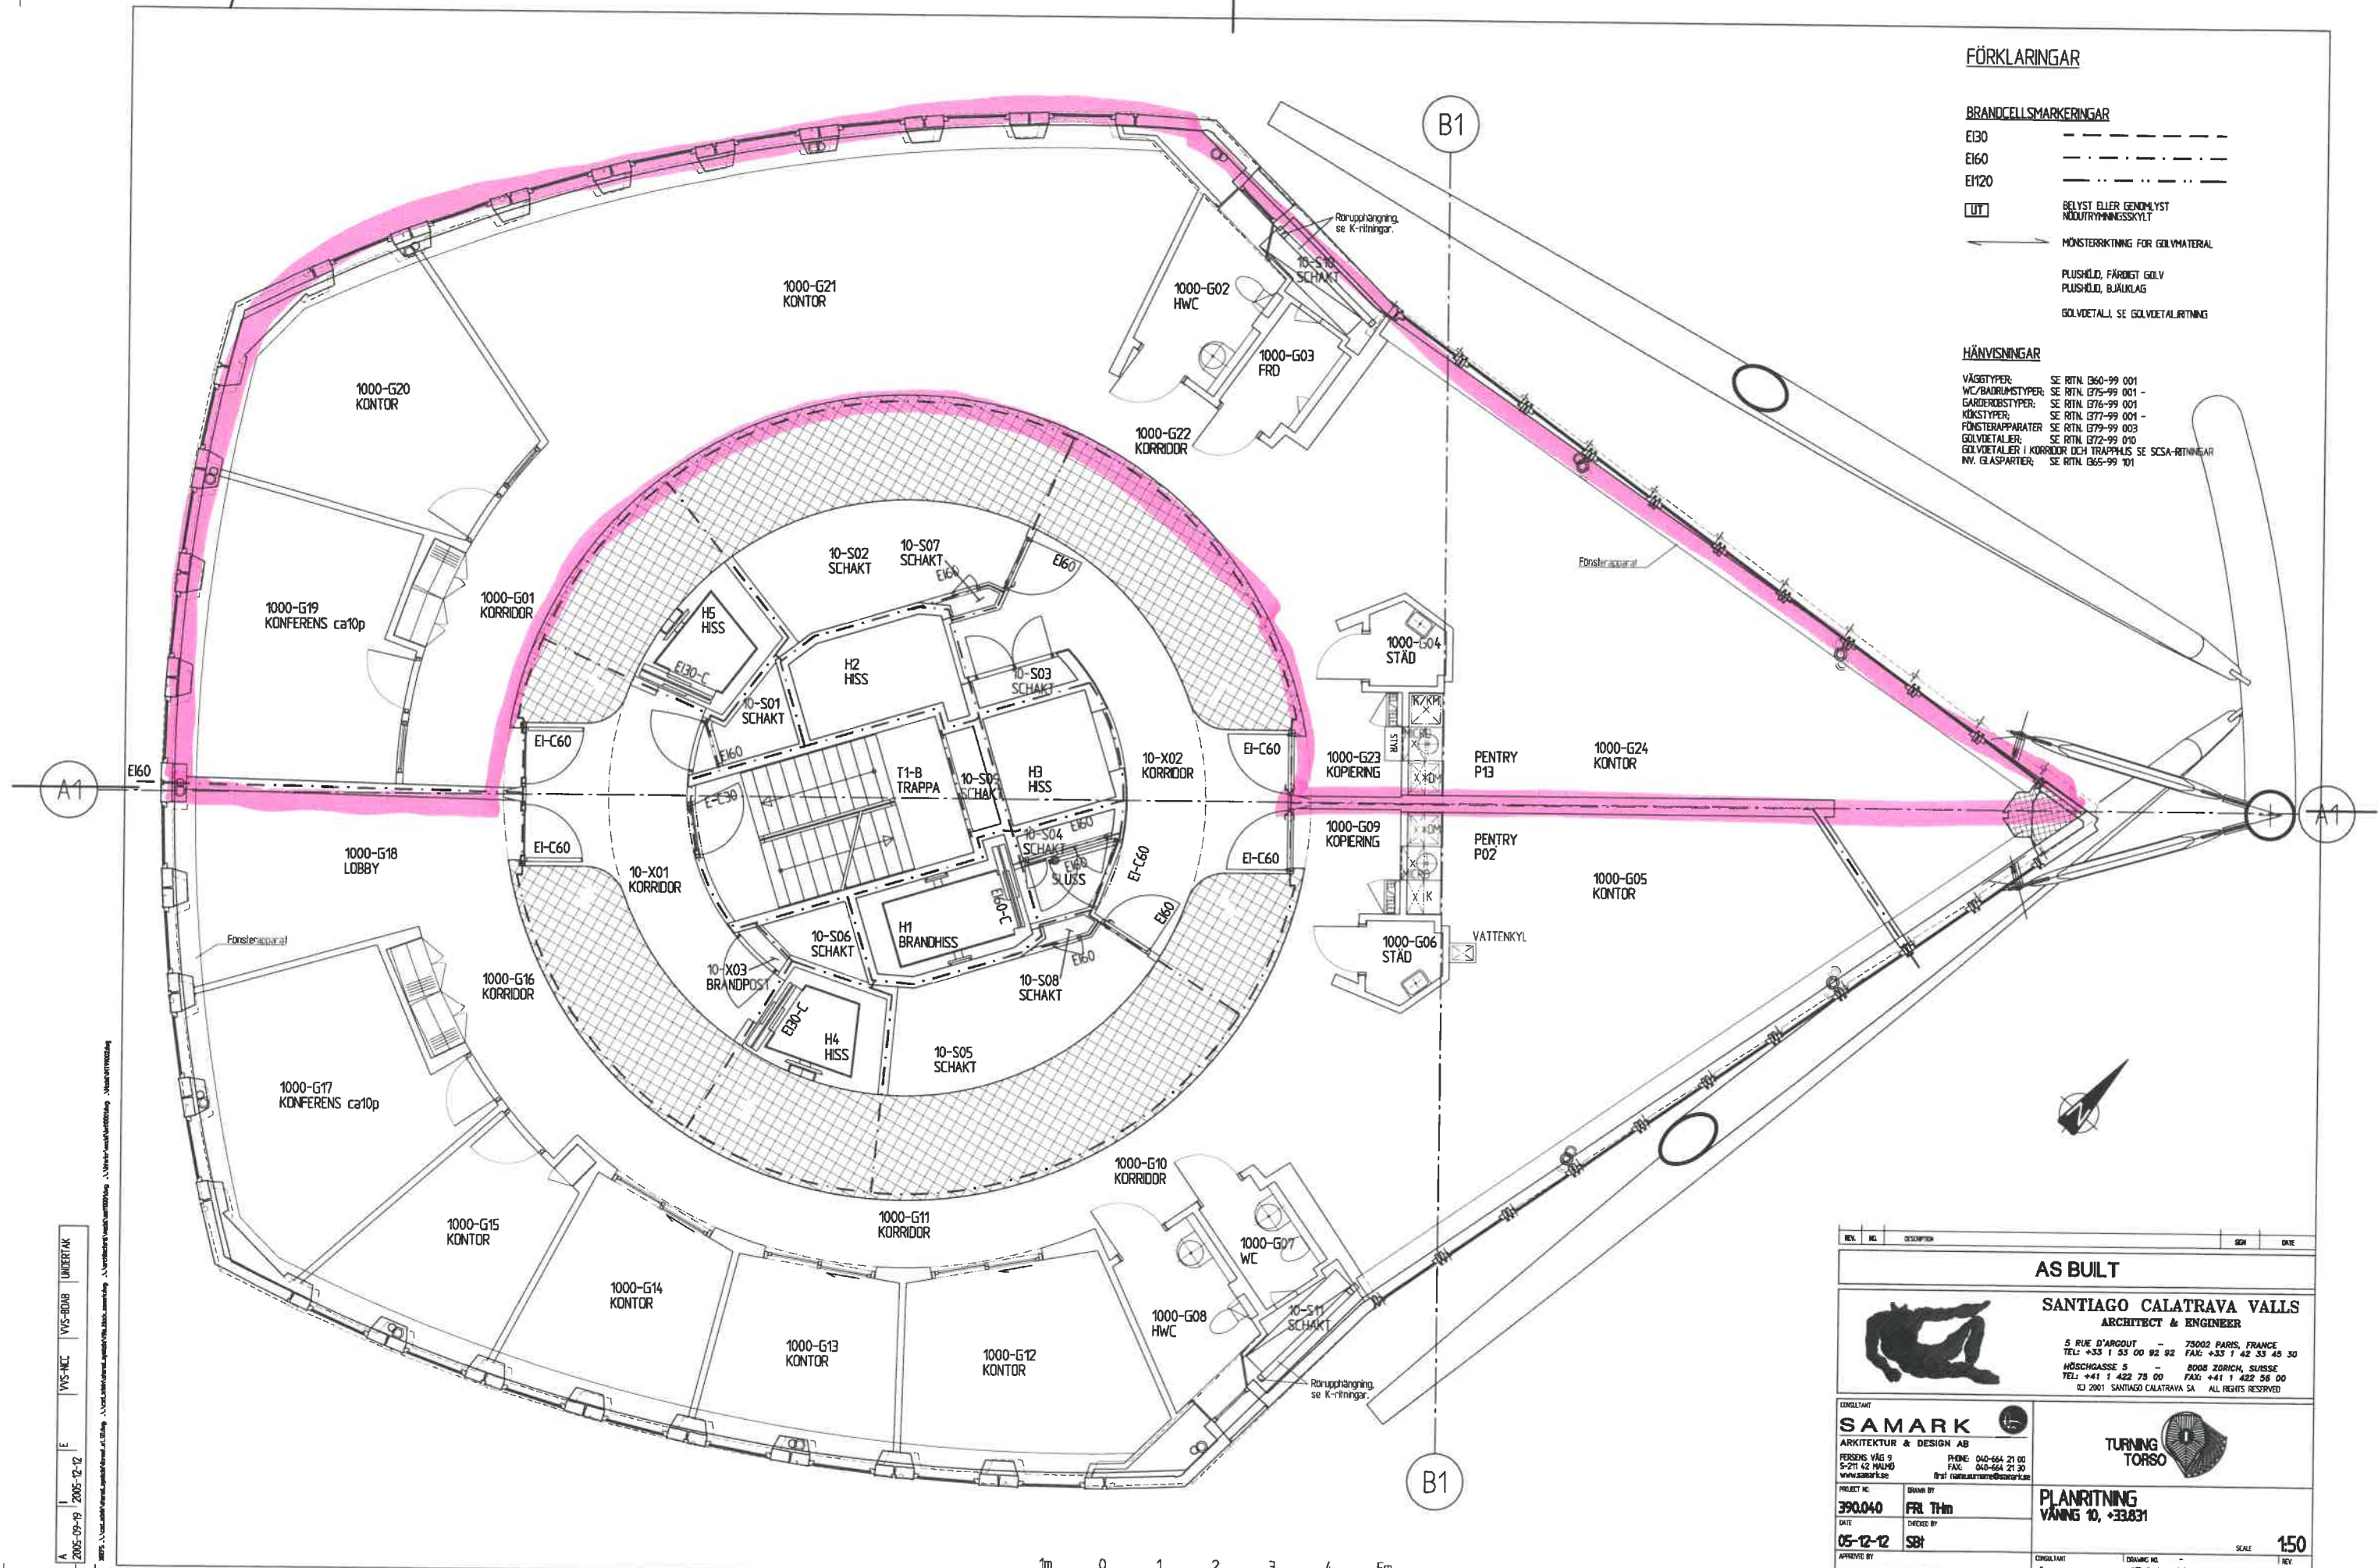

REV.	NO.	DESCRIPTION	SEN	DATE
AS BUILT				
SANTIAGO CALATRAVA VALLS ARCHITECT & ENGINEER				
5 RUE D'ARGOUT - 75002 PARIS, FRANCE TEL: +33 1 53 00 92 92 FAX: +33 1 42 33 45 30 HÜSCHGASSE 5 - 8008 ZÜRICH, SUISSE TEL: +41 1 422 79 00 FAX: +41 1 422 56 00 © 2001 SANTIAGO CALATRAVA SA ALL RIGHTS RESERVED				
CONSULTANT SAMARK ARKITEKTUR & DESIGN AB PERSENS VÄG 9 S-211 42 MALMÖ WWW.SAMARK.SE		PHONE: 040-664 21 00 FAX: 040-664 21 30 E-MAIL: info@samark.se		
PROJECT NO.	390.040	DESIGNED BY	FR Thm	DATE
DATE	05-12-12	DESIGNED BY	SBT	DATE
APPROVED BY	STEFAN BERGMVIST	CONSULTANT	1	DESIGN NO.
				B04-10 001
				SCALE
				150
				REV
				X

WVS-MEC WVS-BDAB LINBERTAK
 A 2005-09-19 2005-12-12